


PLAN 4

REF.
LAGER:

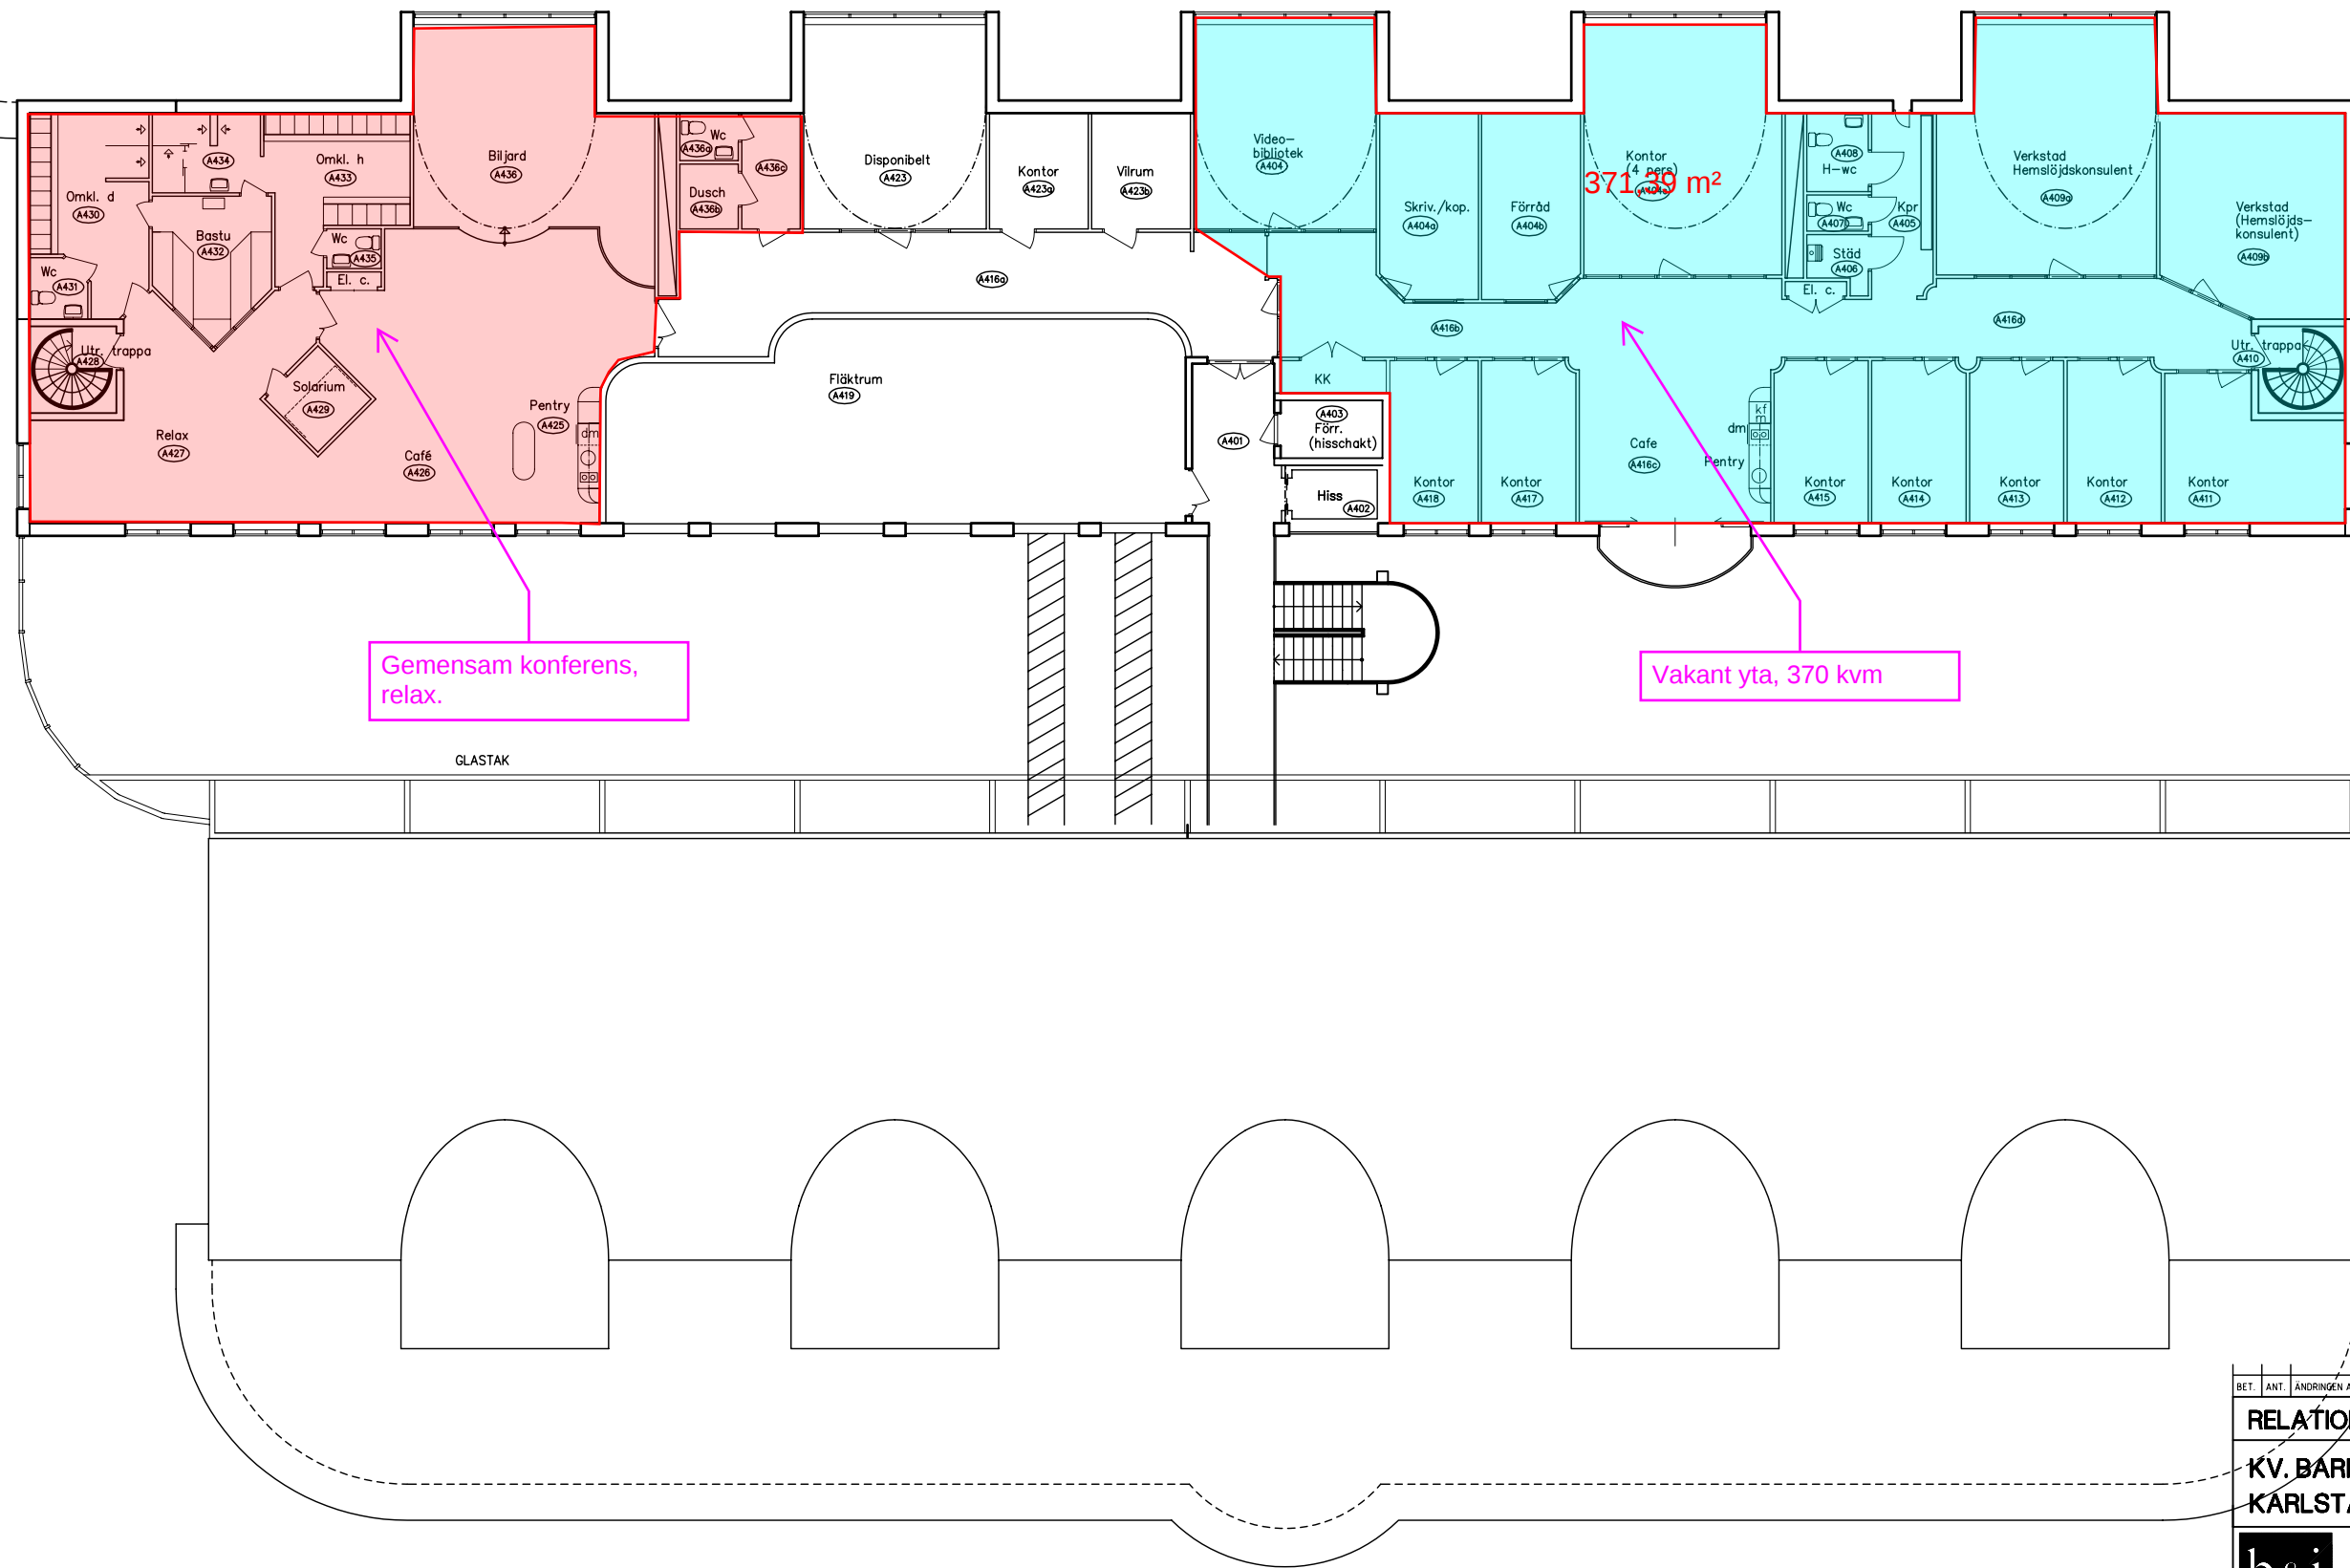

BET.	ANT.	ÄNDRINGEN AVSEER	DATUM	SIGN.
RELATIONSHANDLING				
KV. BARKASSEN 8				
KARLSTAD				
		bergfjord & ivarson arkitekter AB		
		ingenjörer SBR 881 09 karlstad tel 054-10 08 88		
ARB.NR 0736		RITAD S.L.		L.E.
DATUM 07-11-09		ANSVARIG		L.E.
KLÖVERN AB				
PLAN 4				
SKALA 1:100		RITN.NR.		BET.
SKALA A3 1:200		R303:4		

PLÖ: 2007-11-09 13:28 P:\2007\0736\Klöver\KV Barkassen\Relationshandling\KV Barkassen\Plan 4.dwg Ingvar