


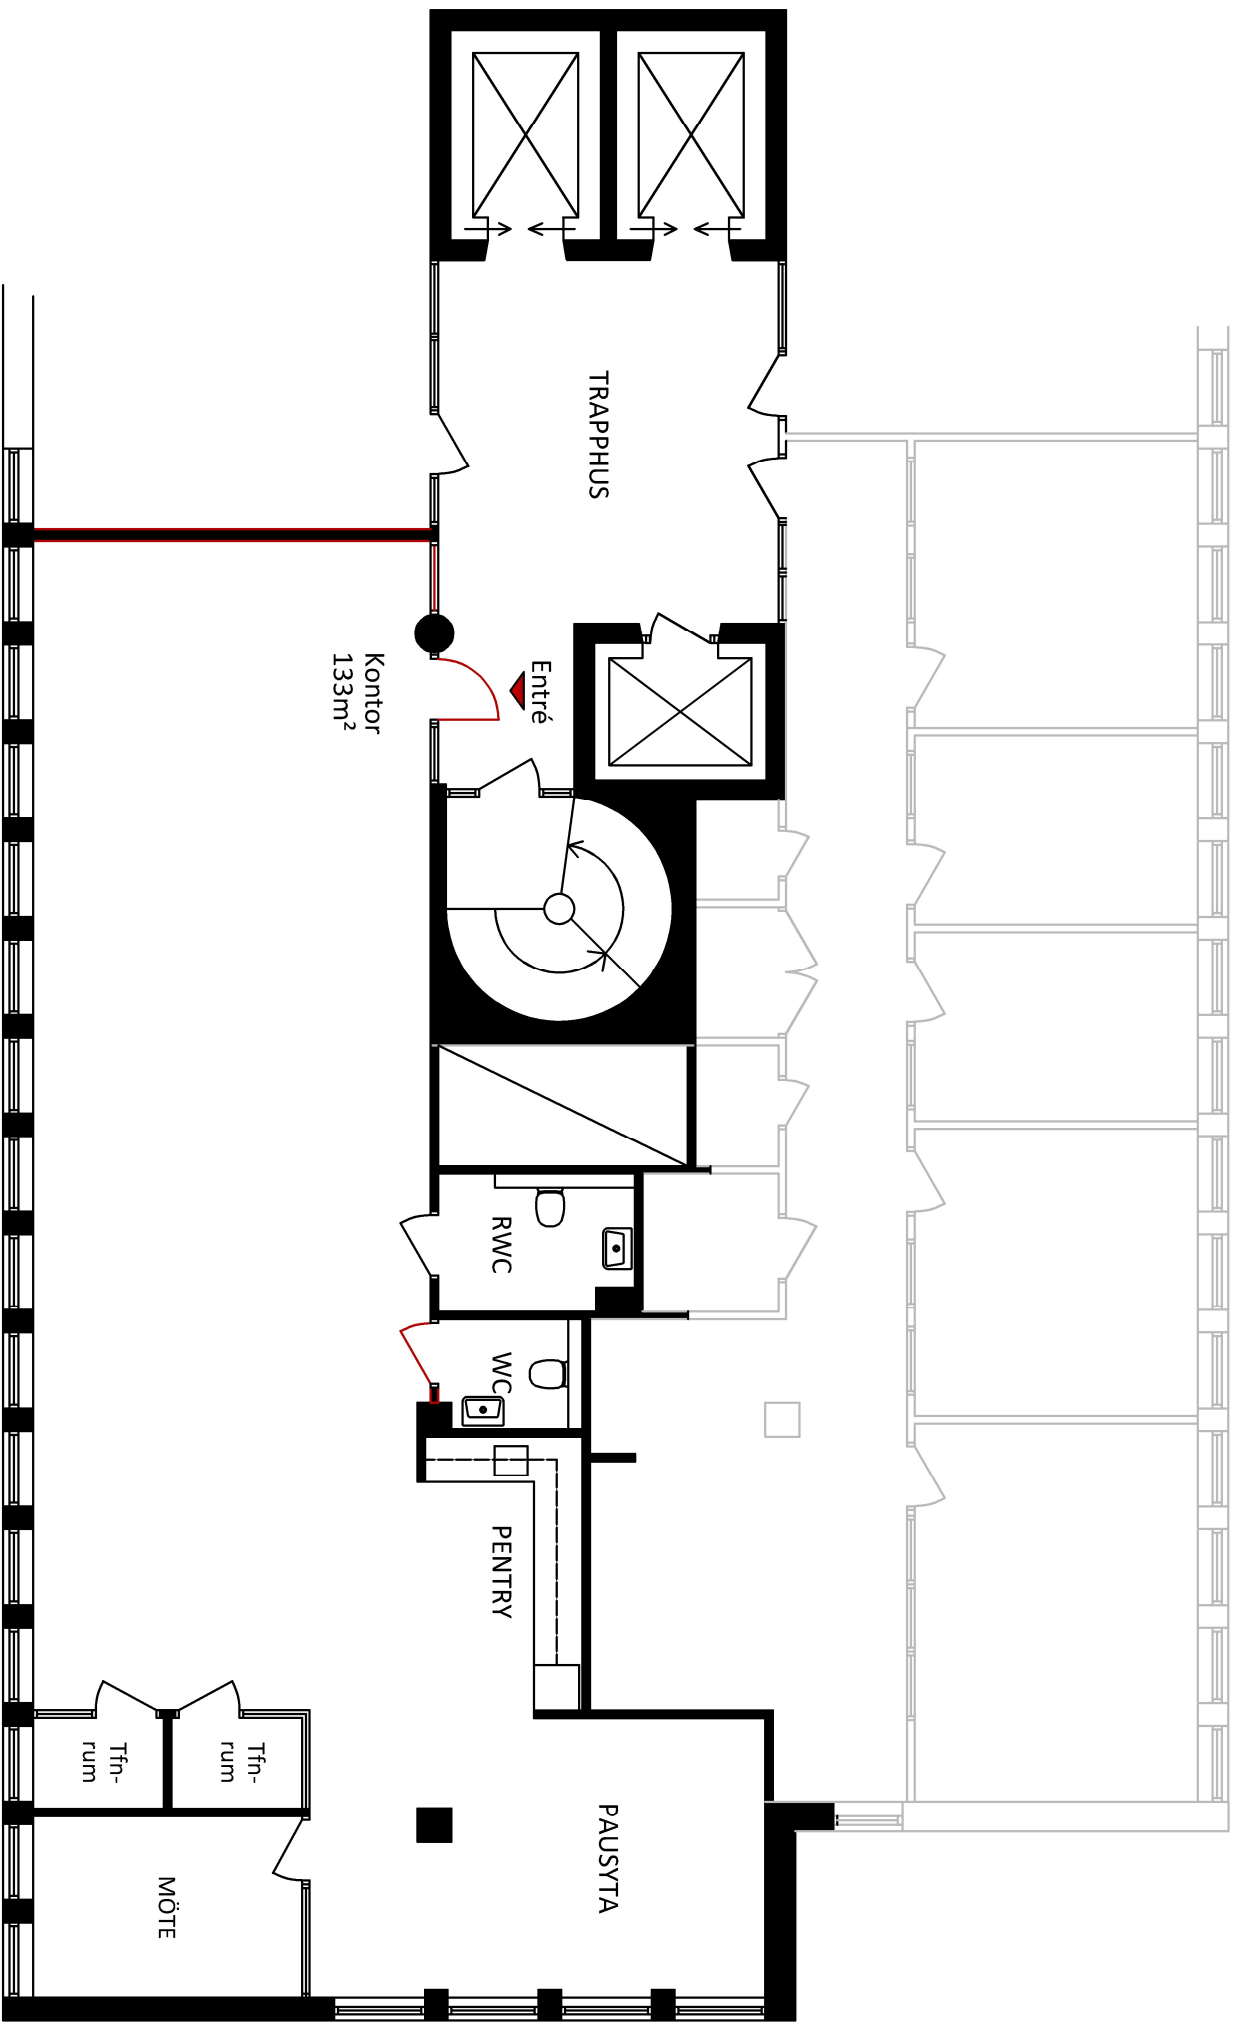

0 5m
SKALA 1:100 (A4)

Relationshandling 2025-05-05
KV. VINPELN - PLAN 6 - Kontor 133m²