



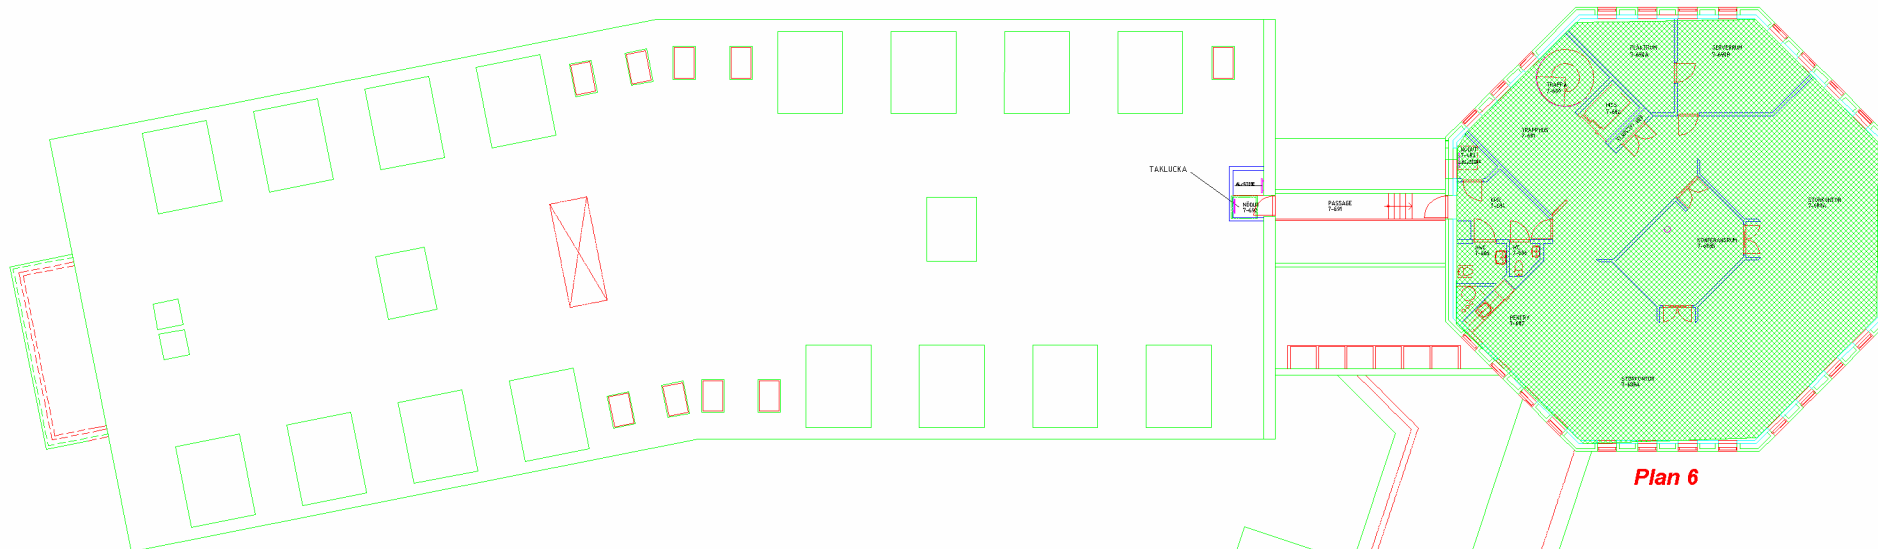

PLAN 6 VIND

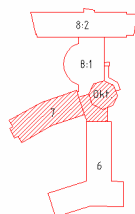

A	Allmän revidering	MMe	20030401
Rev.	Revideringen avser	Sign.	Datum
RELATIONSRITNING			
Soft Center			7
RONNEBY			Plan 6
Ritad	Datum	Skala	Ritn.nr
Fogelberg	1999	1:200	A:760
Rev.		A	