


Planritning – Pendelgatan 2

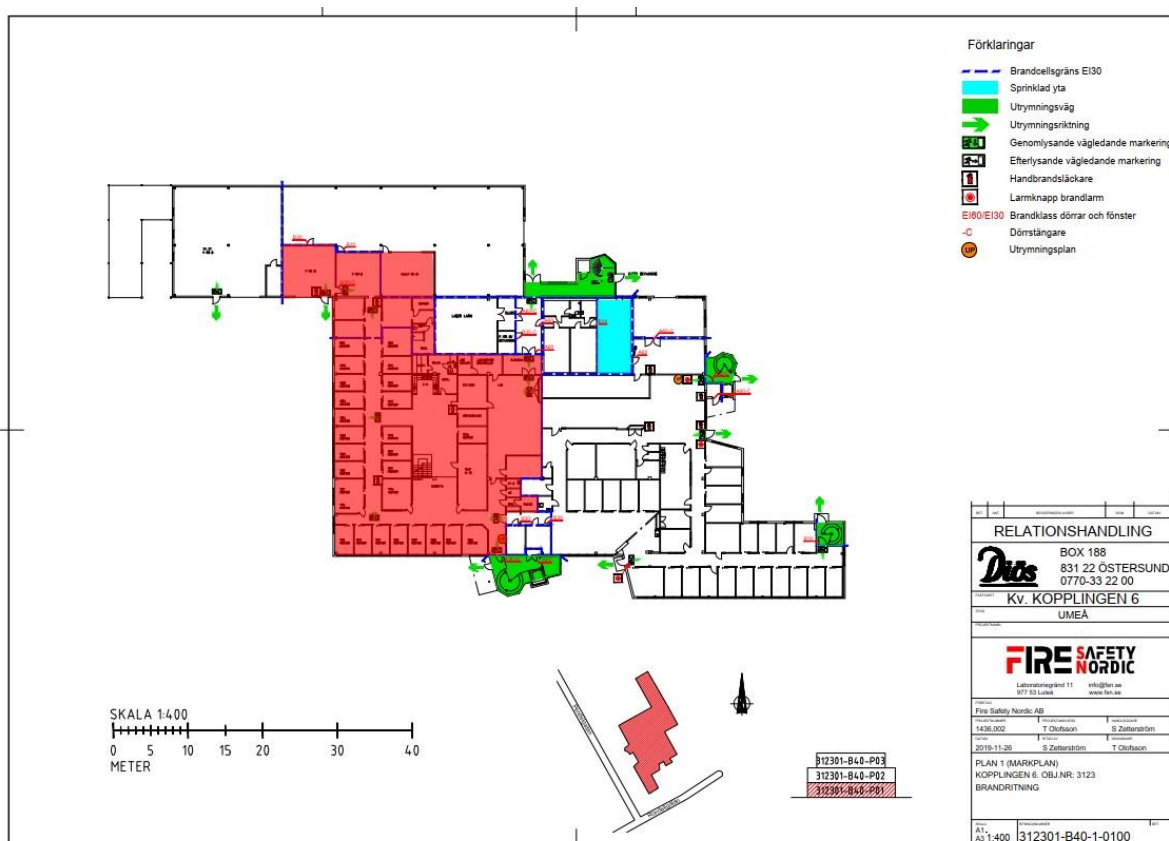

Planritning – Pendelgatan 2

