

2013 -01- 0 2

Dnr: 2013-1006-1

RWC 2.20 x 2.20

M 21 - 616
Kv


M 22 - 508
Kv

M 22 - 508
Kv

M 22 - 508
Kv

M 21 - 510
Kv

M 22 - 514
Kv

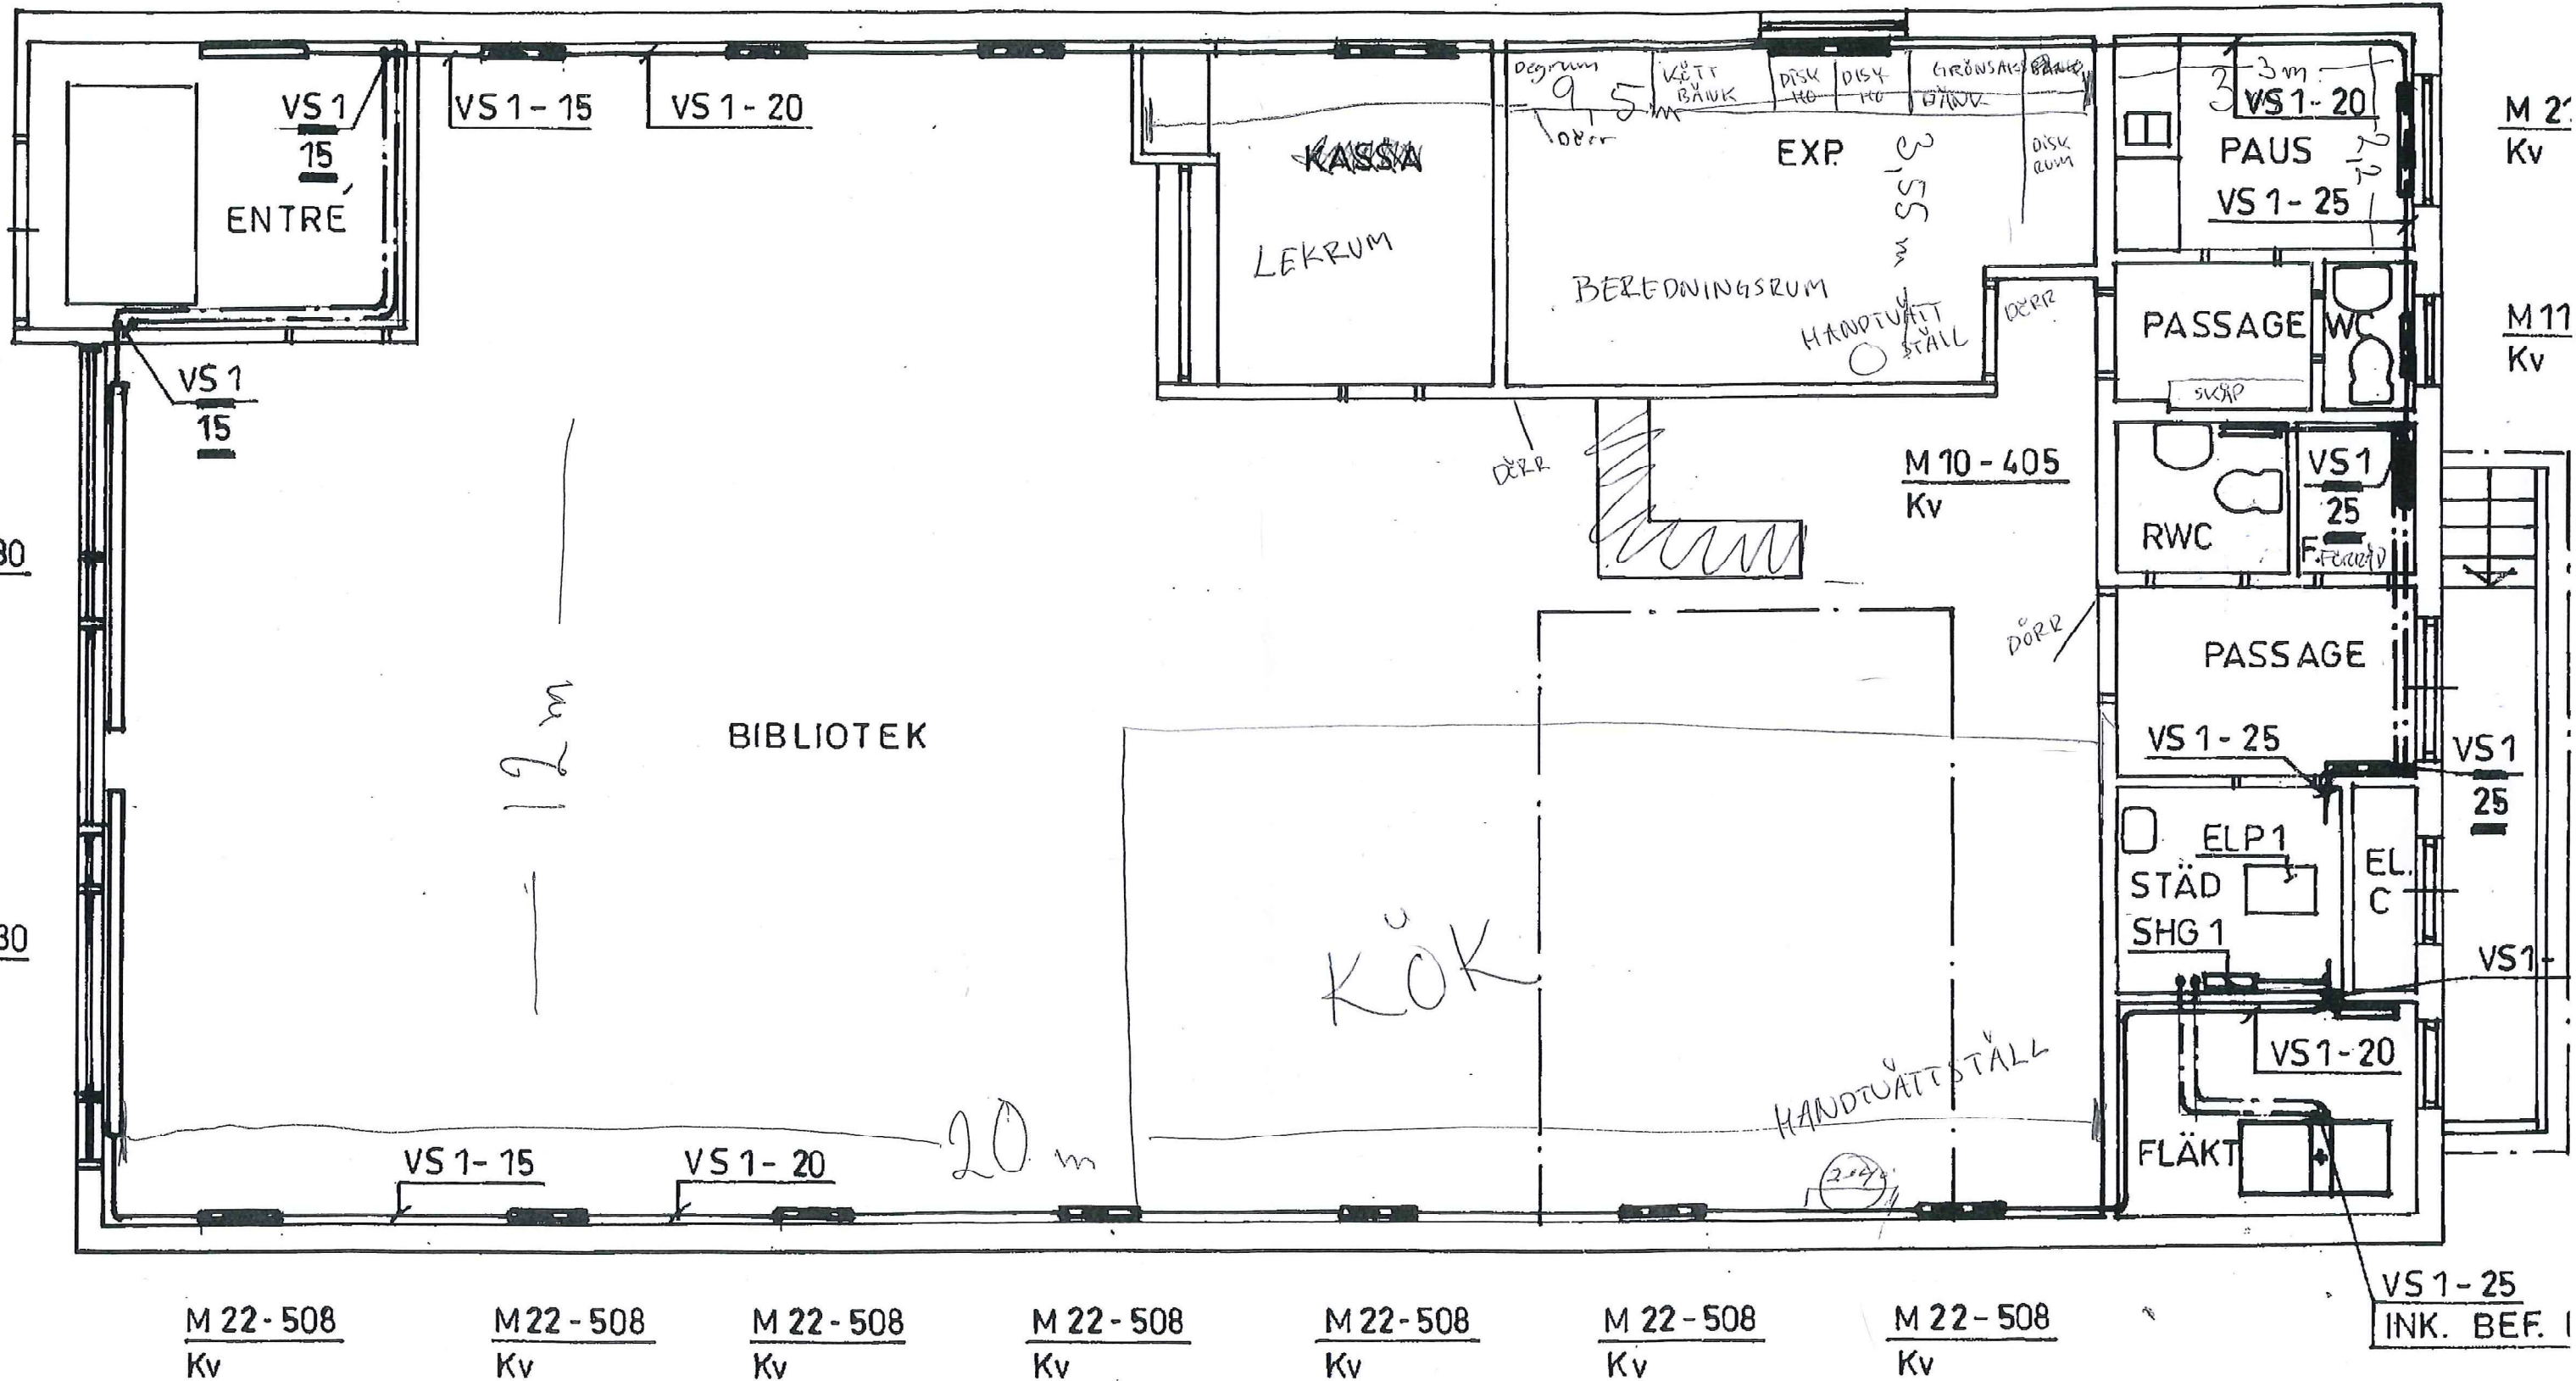

VS 1 - 25
INK. BEF. I

planritning