


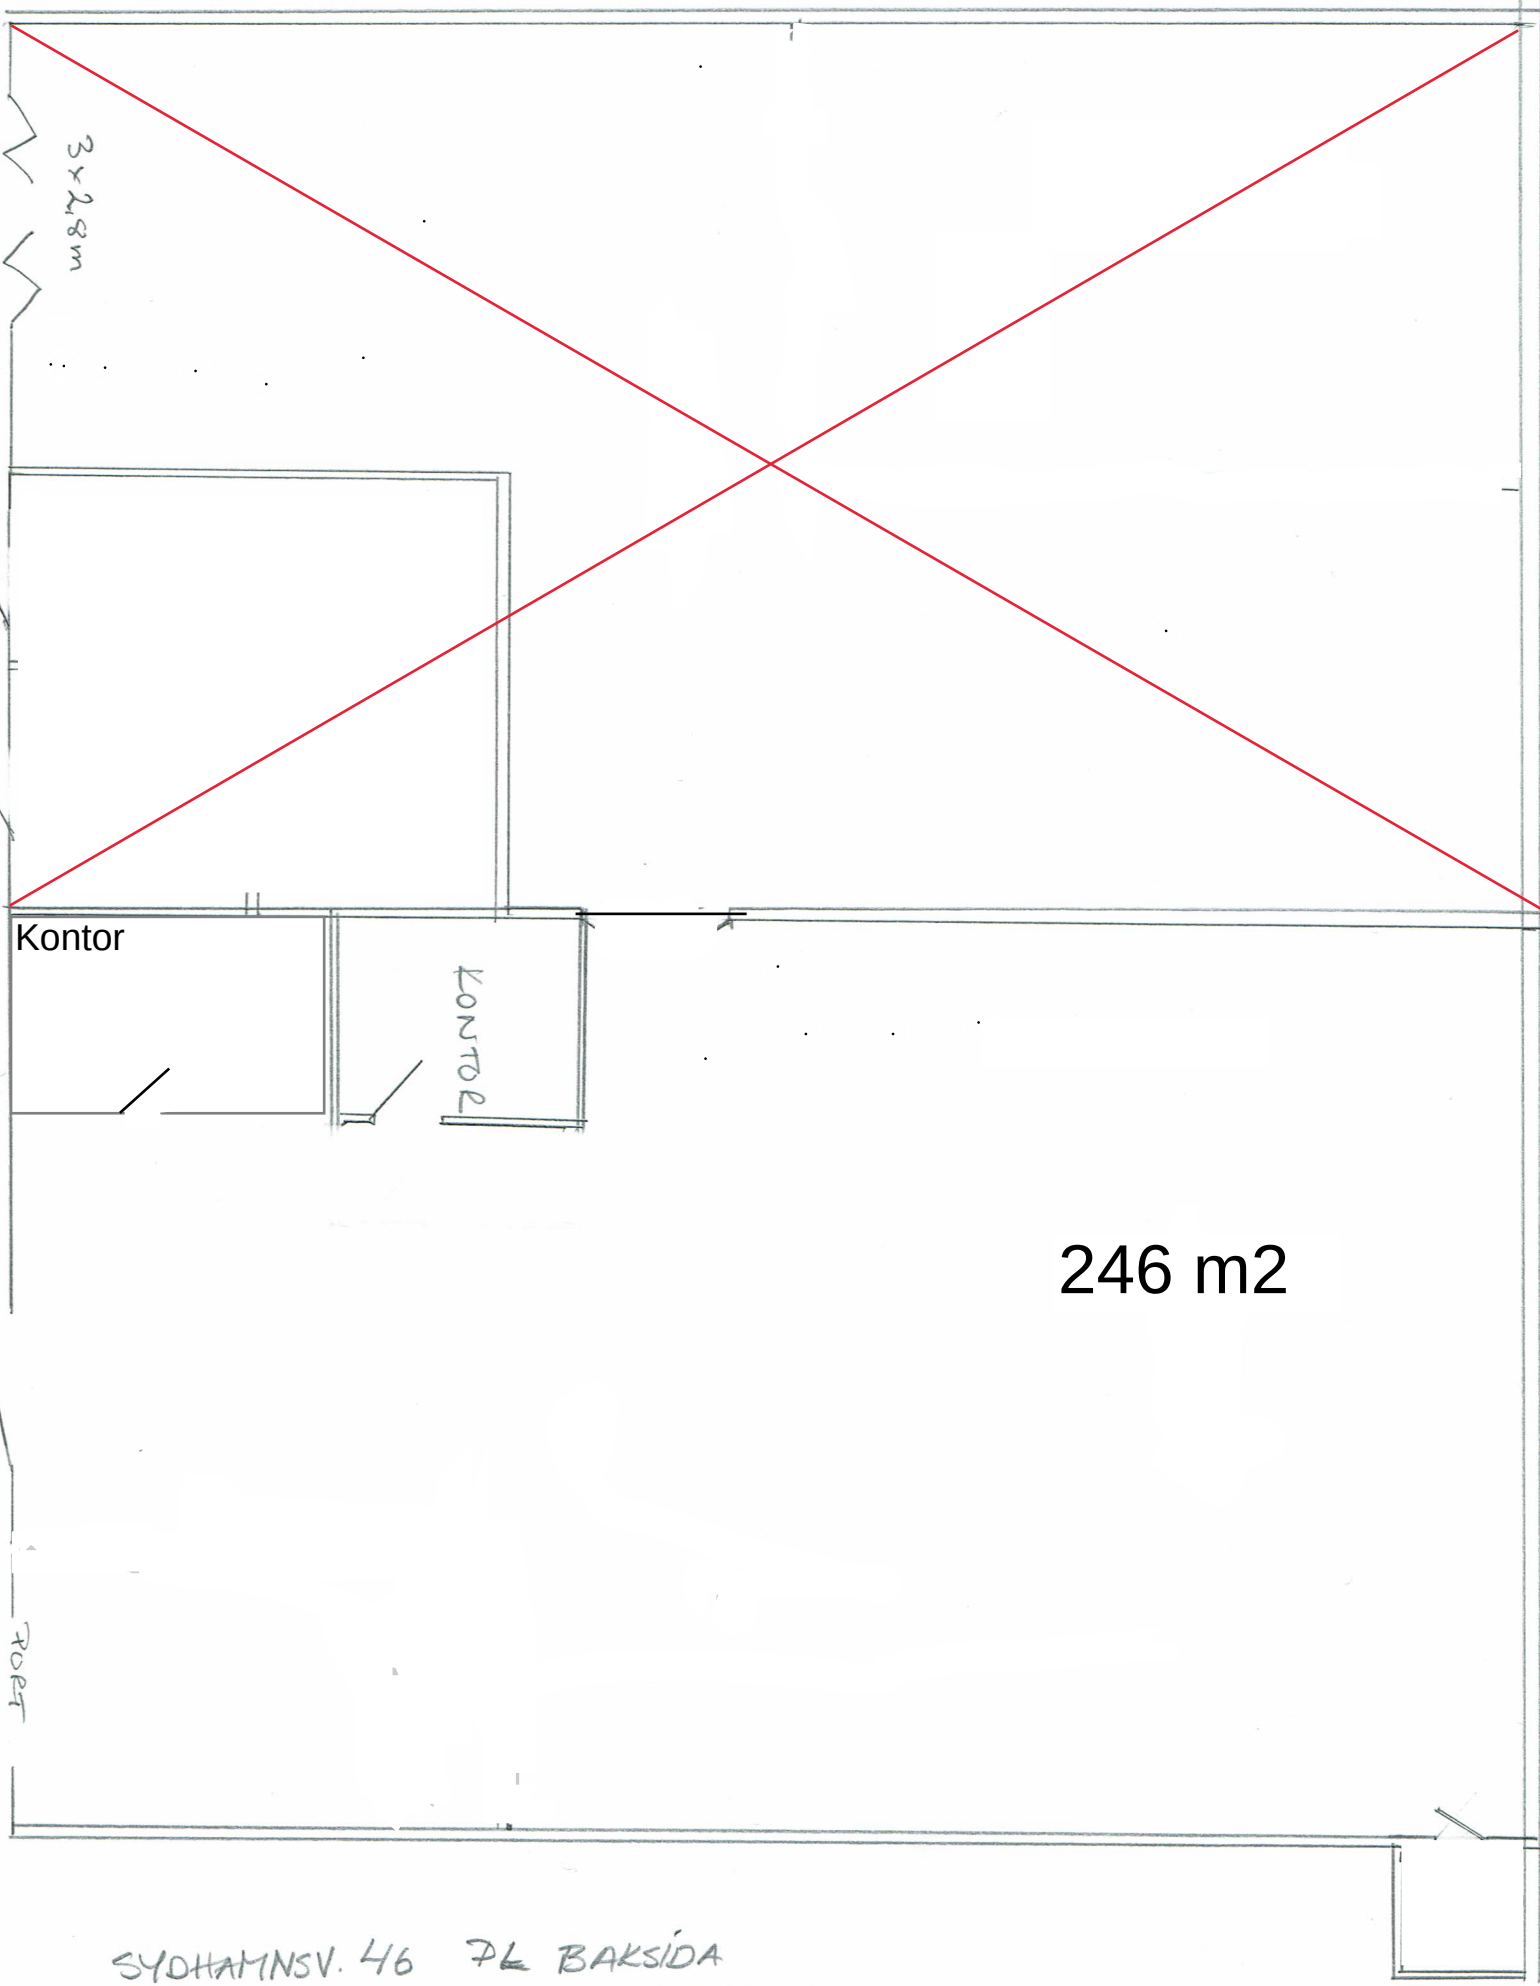

SYDHAMNSV. 46 76 BAKSIDA
SKALA ~ 1:100 150310 APu