


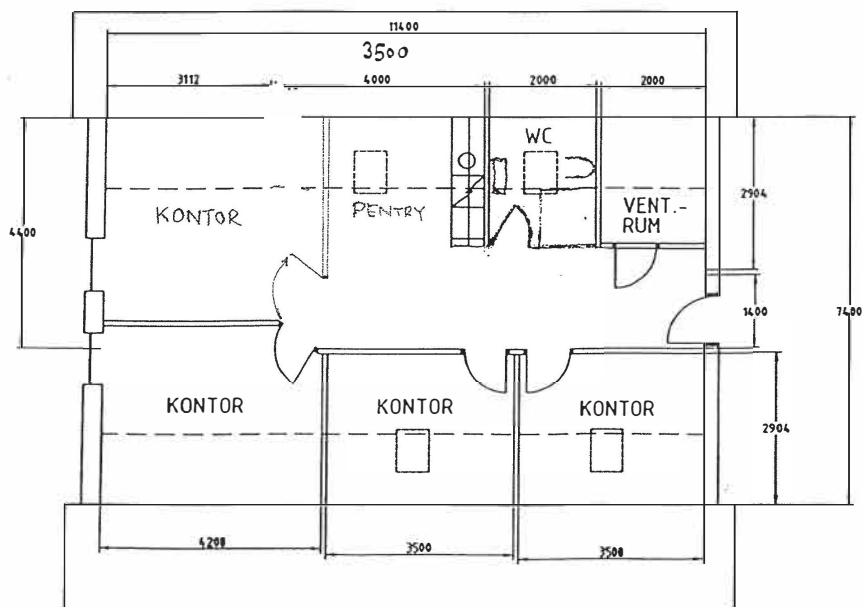

A 1	STANSTORP 1:782
	STAFFANSTORP
	990718
Jörgen Lindahl	1:100