


RELATIONSHANDLING

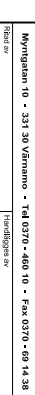

 **CORALIEN I VÄRNAMO AB**
Kv. Bodarna 2, Värnamo

A3 1:100 A1 1:50	2004-058	A300:303	
---------------------	----------	----------	--