


Bil 4

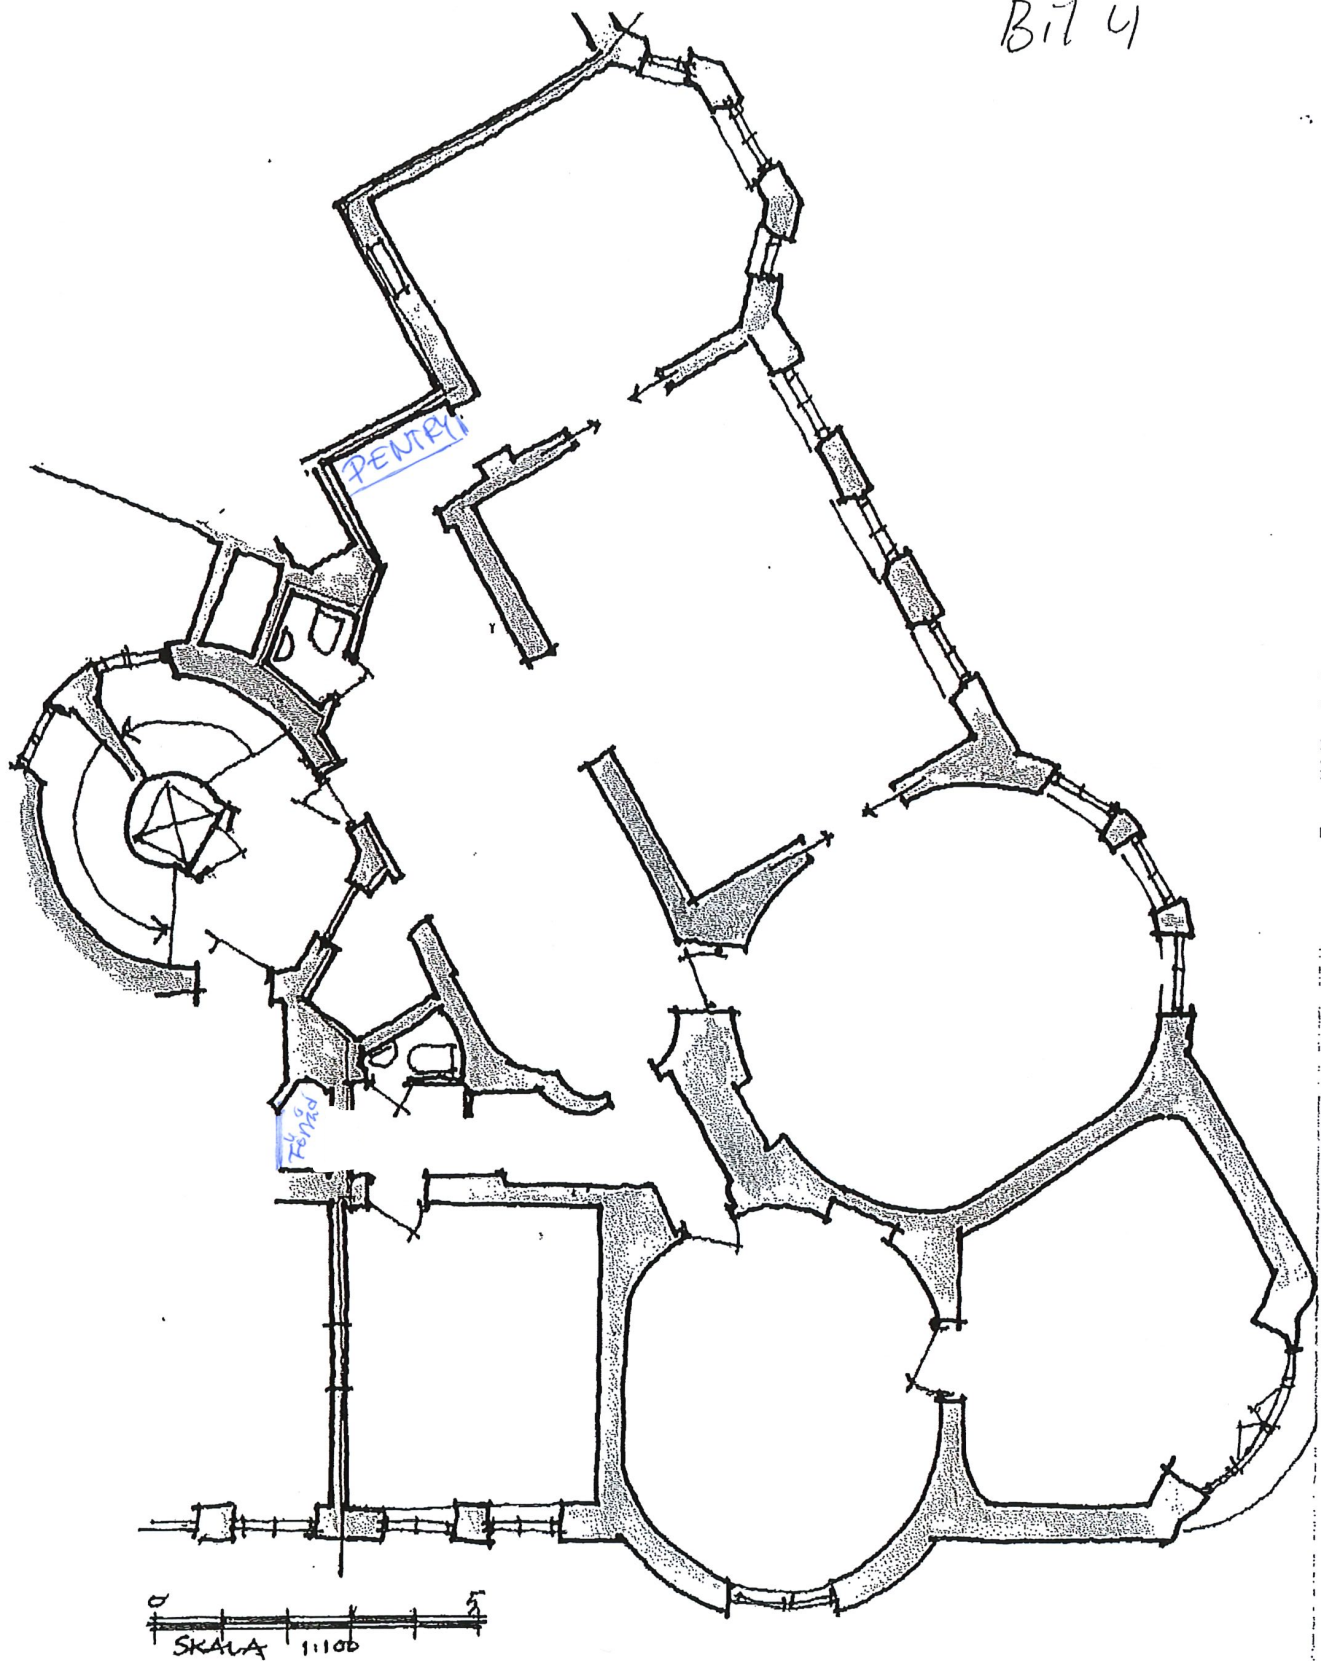

LĂRAREN 2, BARNHUSGATAN 20, 5 TR. LOKAL 228 m<sup>2</sup>.