




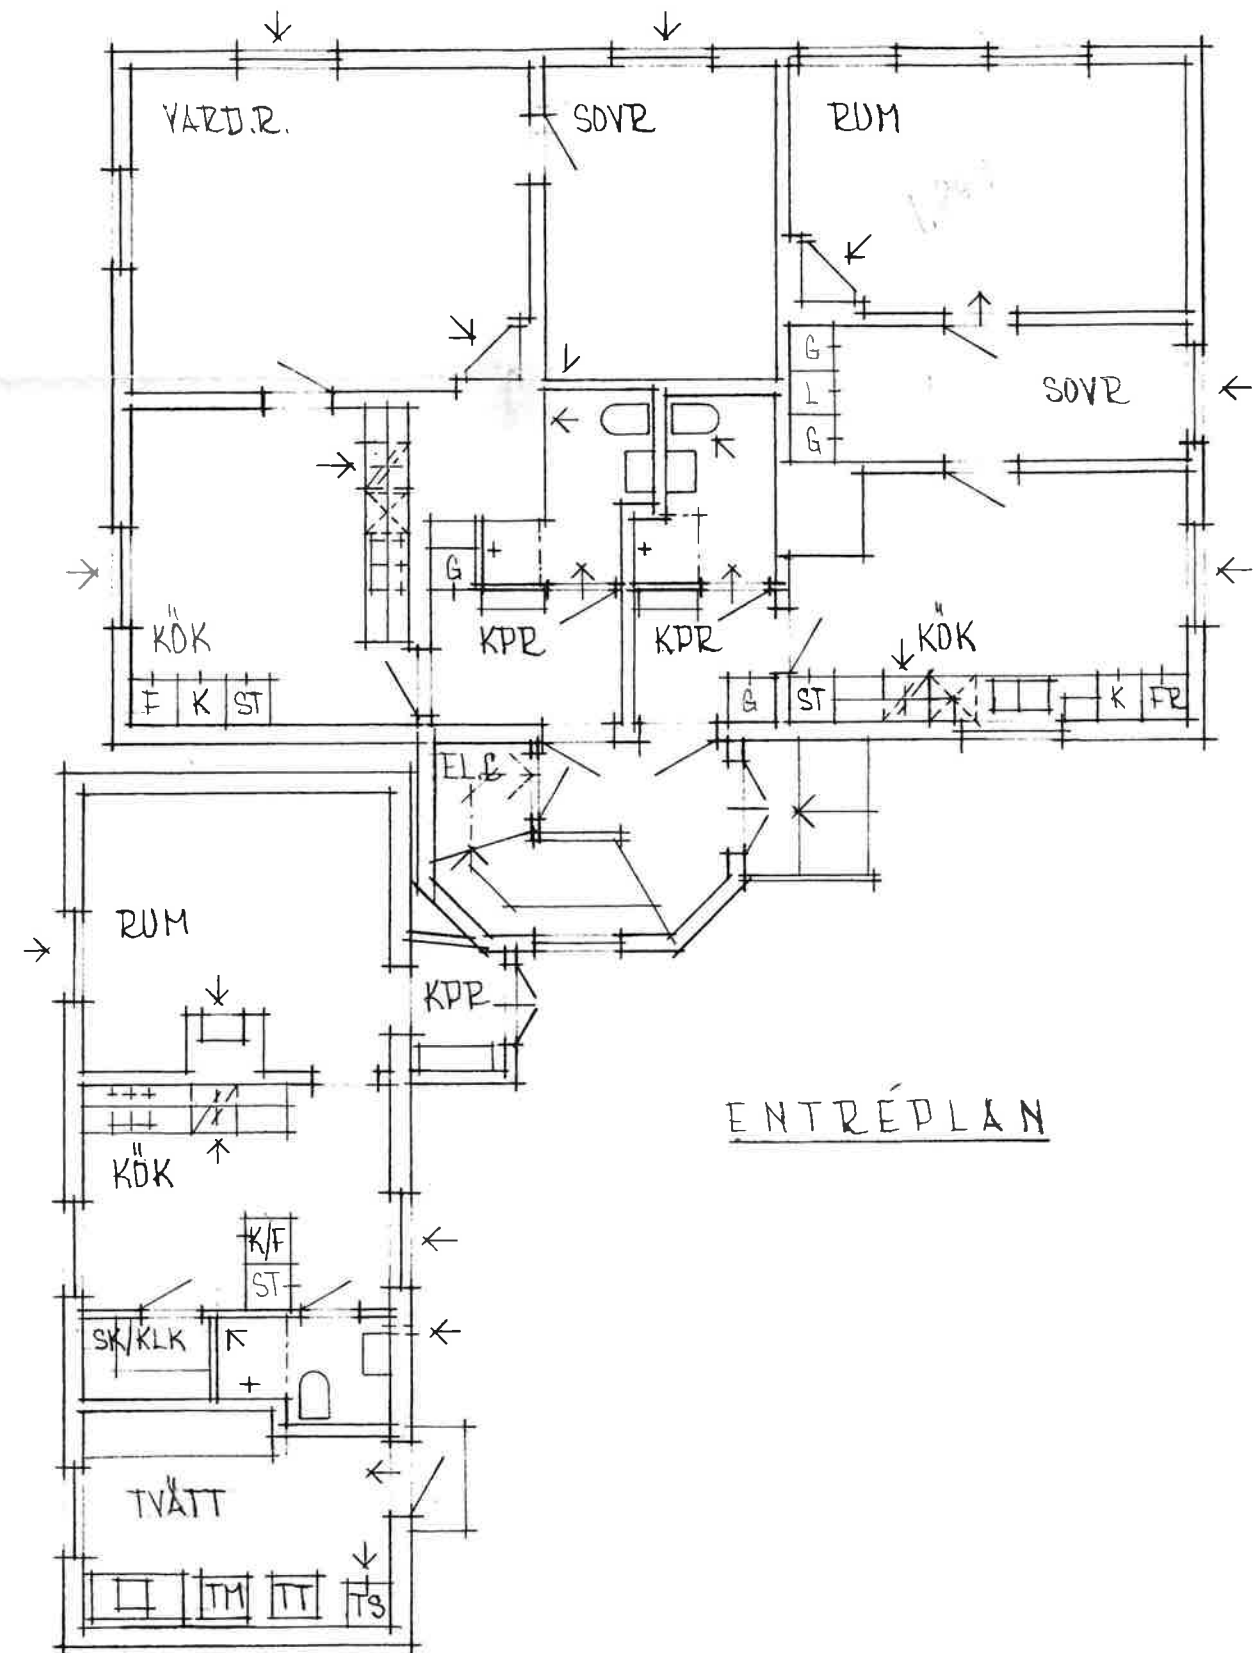

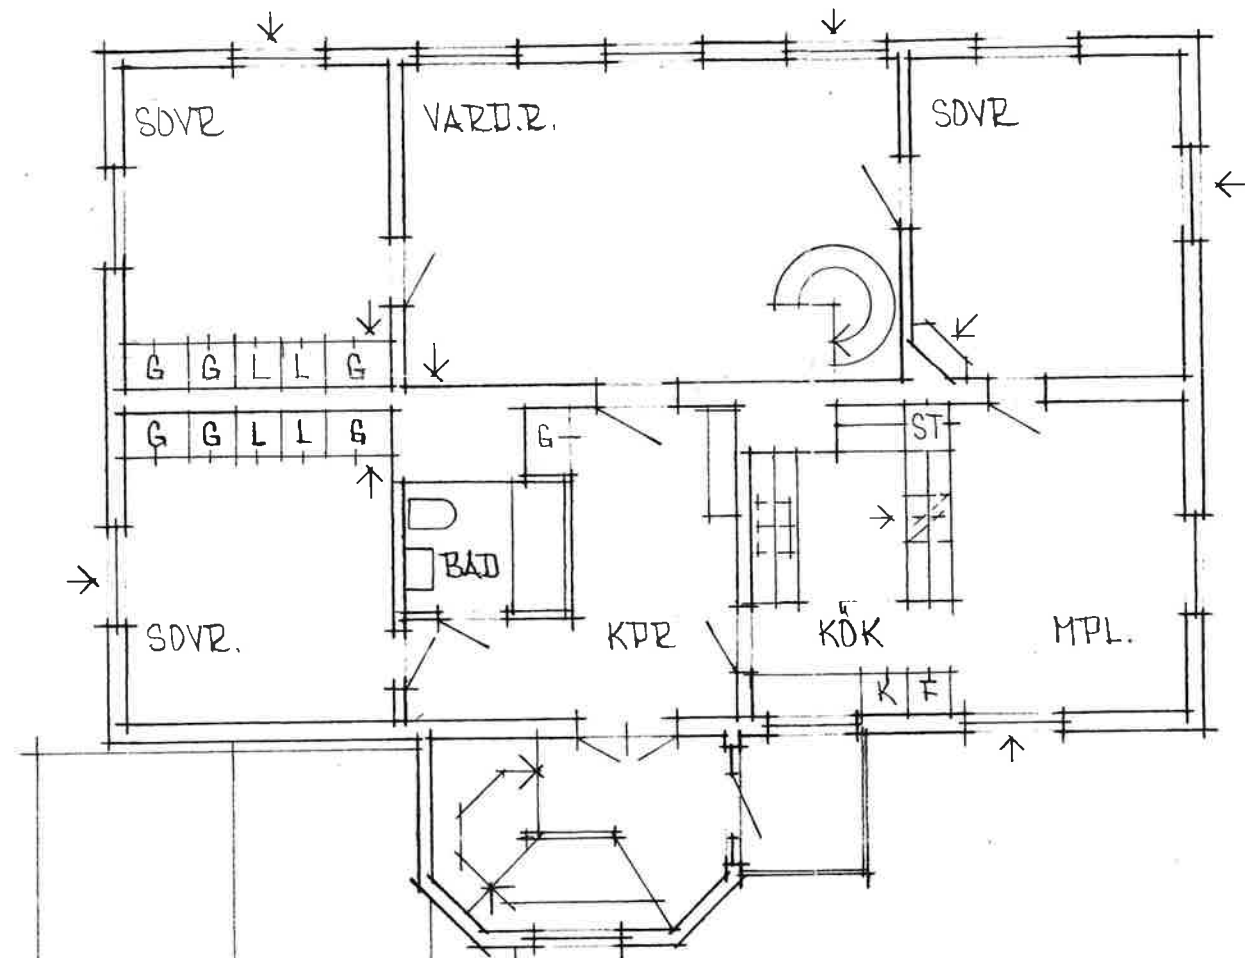

PLAN 1TR

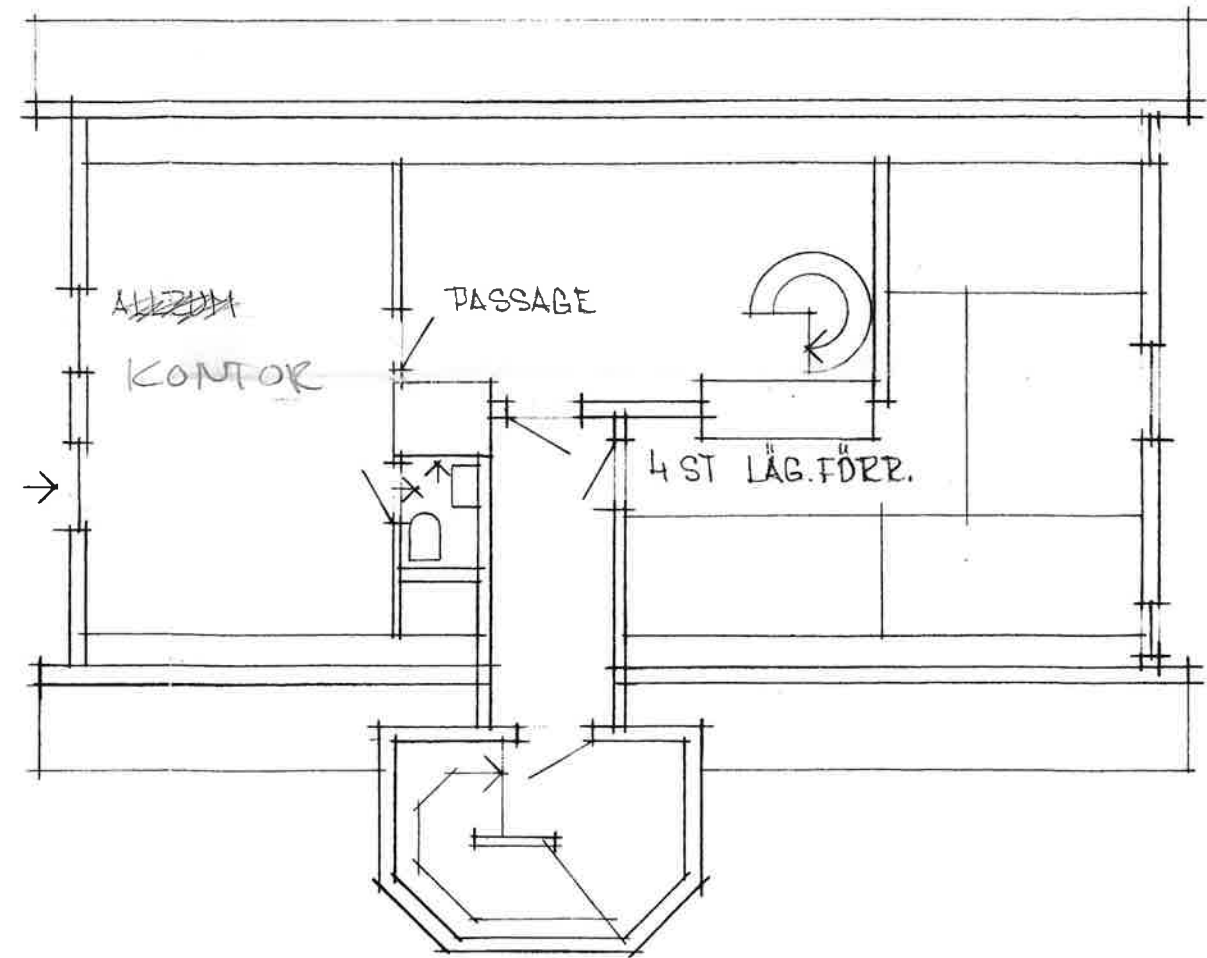

VINDSPLAN

