


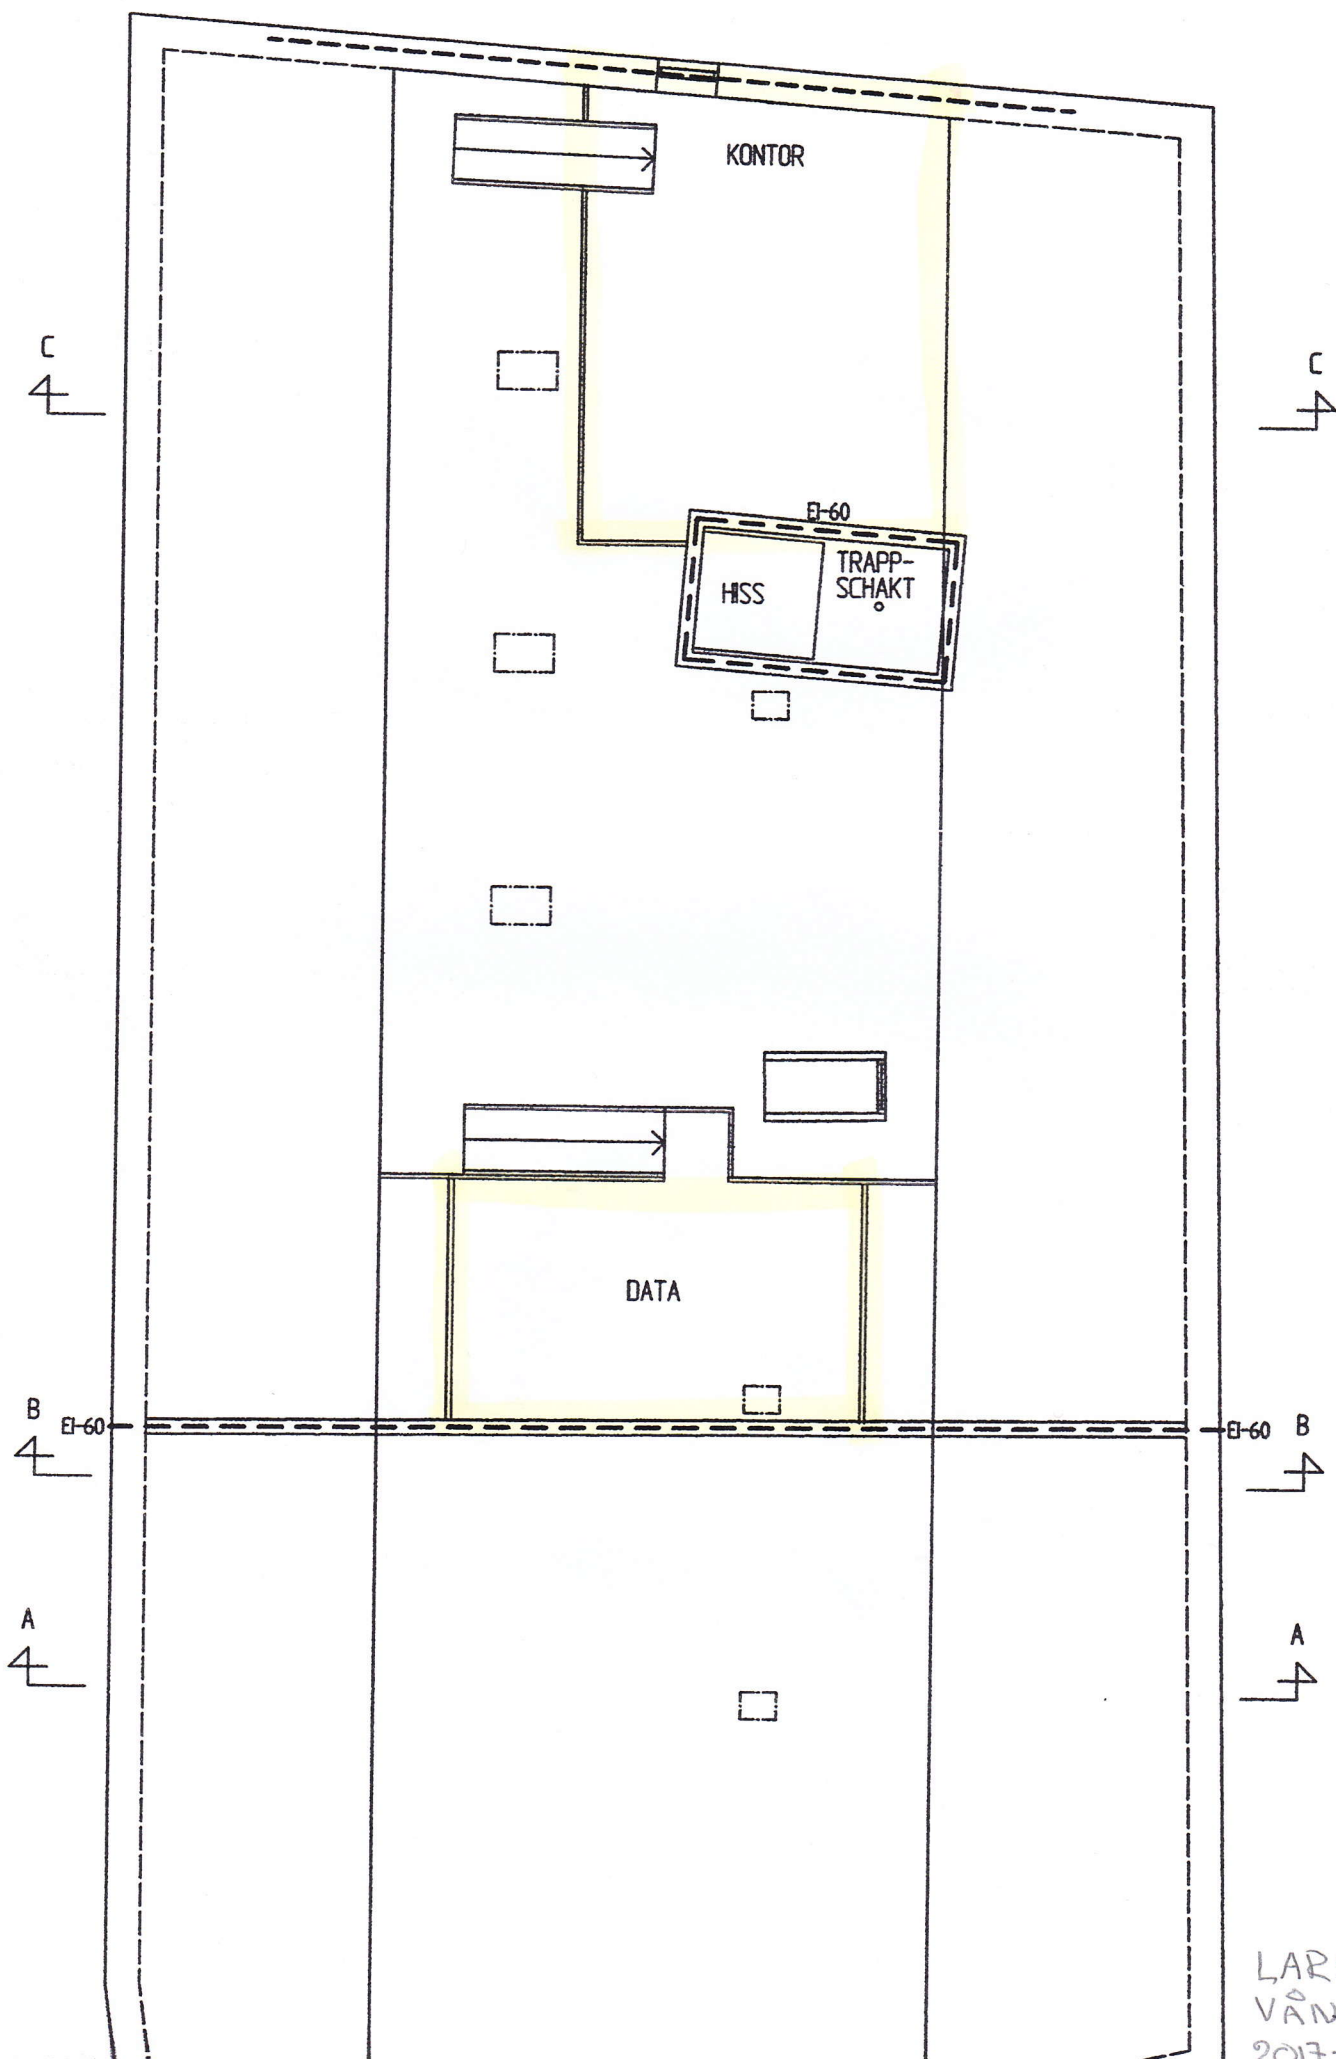

LARS 3
VÂN 4
2017-04-10

F