


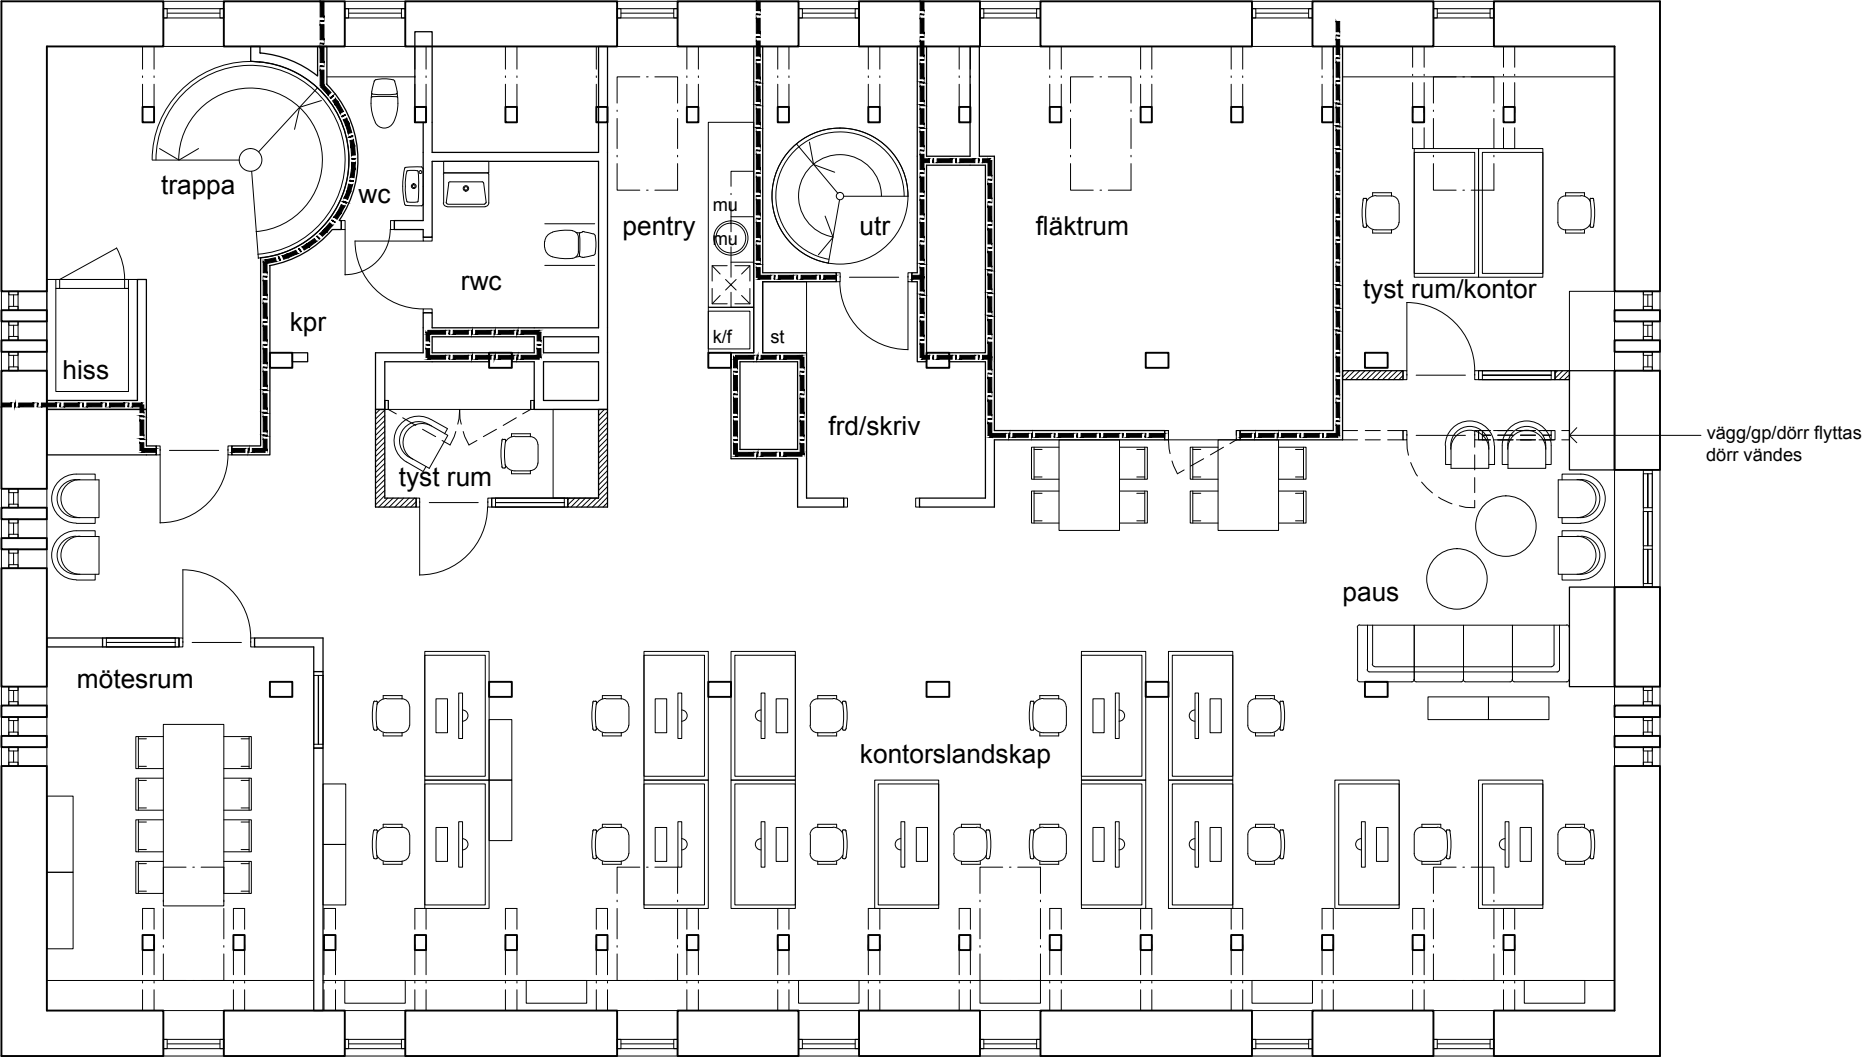

plan 4

idéskiss 2017.05.24

Corem Nyköping

Hamnmagasinet

Kungshagen 1:6 • Nyköping

plan 4
lokaler för ÅF

skala 1:100 (A3)

A-0.1-4