



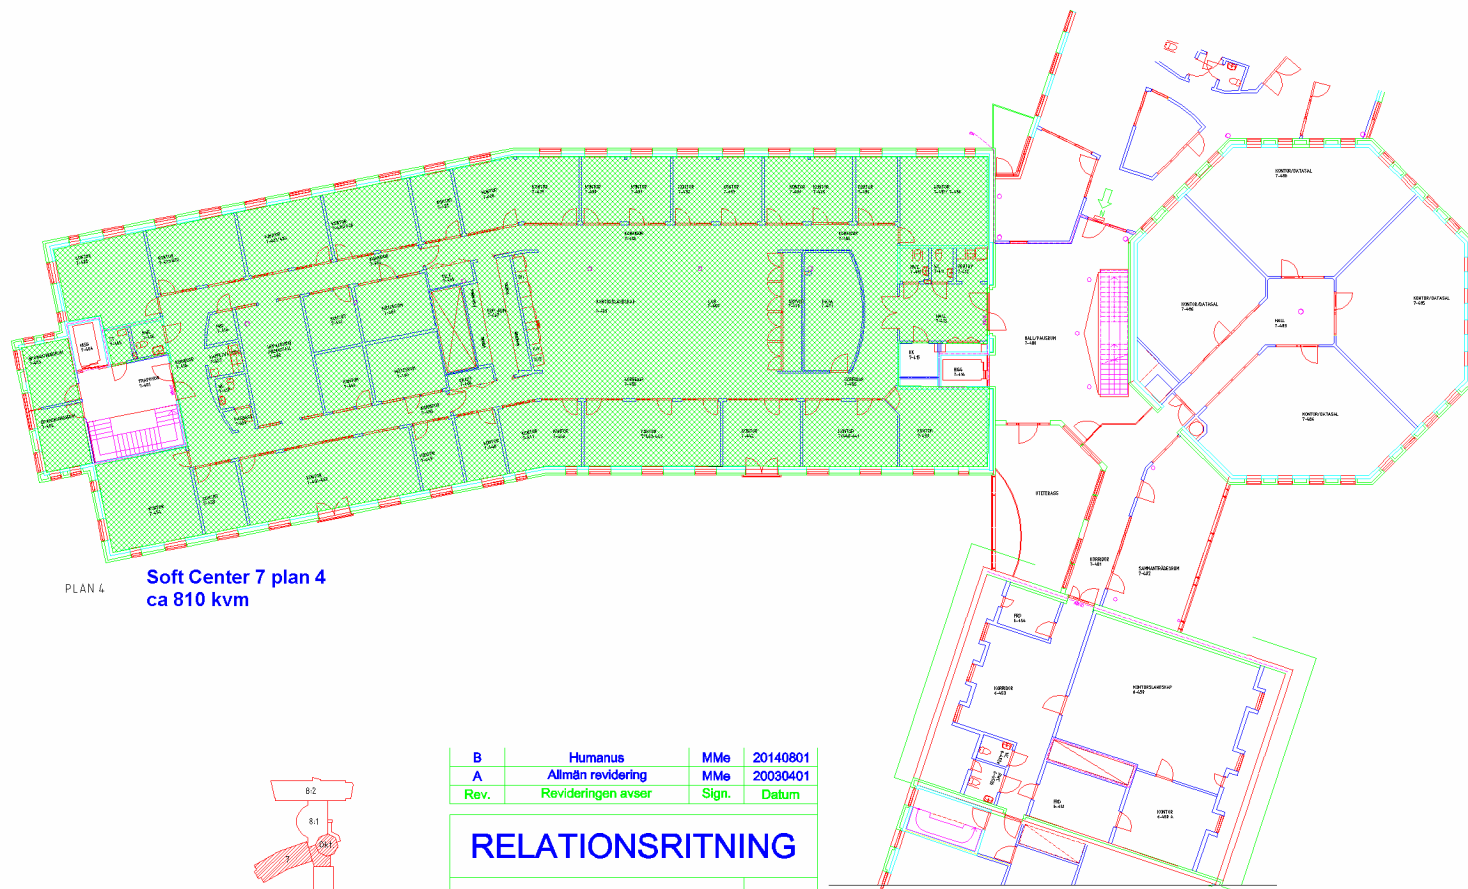

PLAN 4

Soft Center 7 plan 4
ca 810 kvm

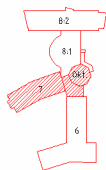

B	Humanus	MMe	20140801
A	Allmän revidering	MMe	20030401
Rev.	Revideringen avser	Sign.	Datum

RELATIONSRTNING

Soft Center		7	
RONNEBY		Plan 4	
Ritad	Datum	Skala	Ritn.nr
Fogelberg	1999	1:200	A:740
Rev.	A		