


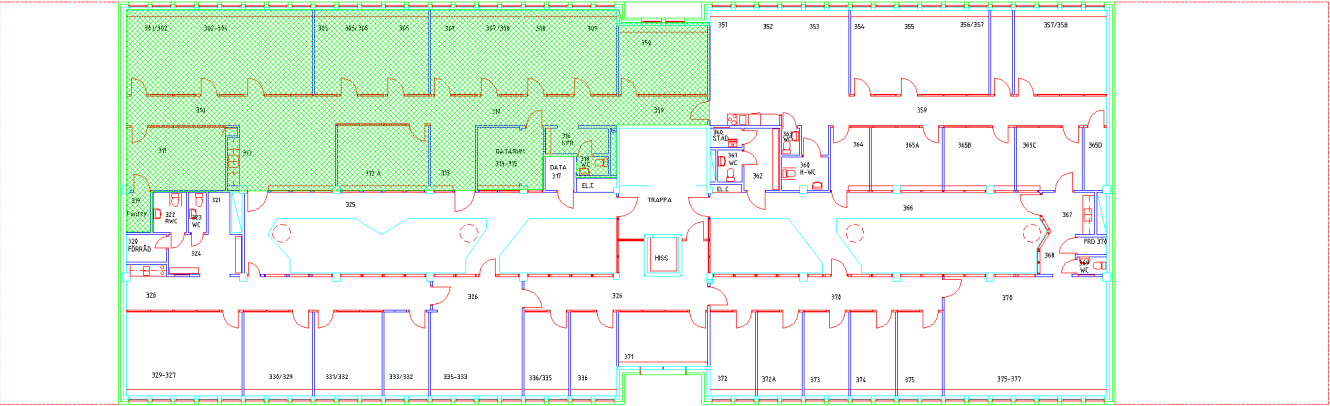

D	Allmän revidering	MMe	20131024
C	Drivkraft 312A	MMe	20070417
B	Capacity	MMe	20080214
A	Allmän revidering	MMe	20030401
Rev.	Revideringen avser	Sign.	Datum

RELATIONSITNING

Soft Center 3

RONNEBY

Plan 3

Ritad	Datum	Skala	Ritm.nr	Rev.
Fogelberg	1990	1:200	A:330	c

